


NO.	DESCRIPTION	DATE

PROJECT NUMBER:	15155.0KCL
DRAWN BY:	H. KVANBECK
CHECKED BY:	B. HUNKE
DATE:	07/13/2015
COMPUTER DIRECTORY:	Jobs\6500 Carlson Drive\05_Dwg

FLOOR PLAN

AS-BUILT

A200

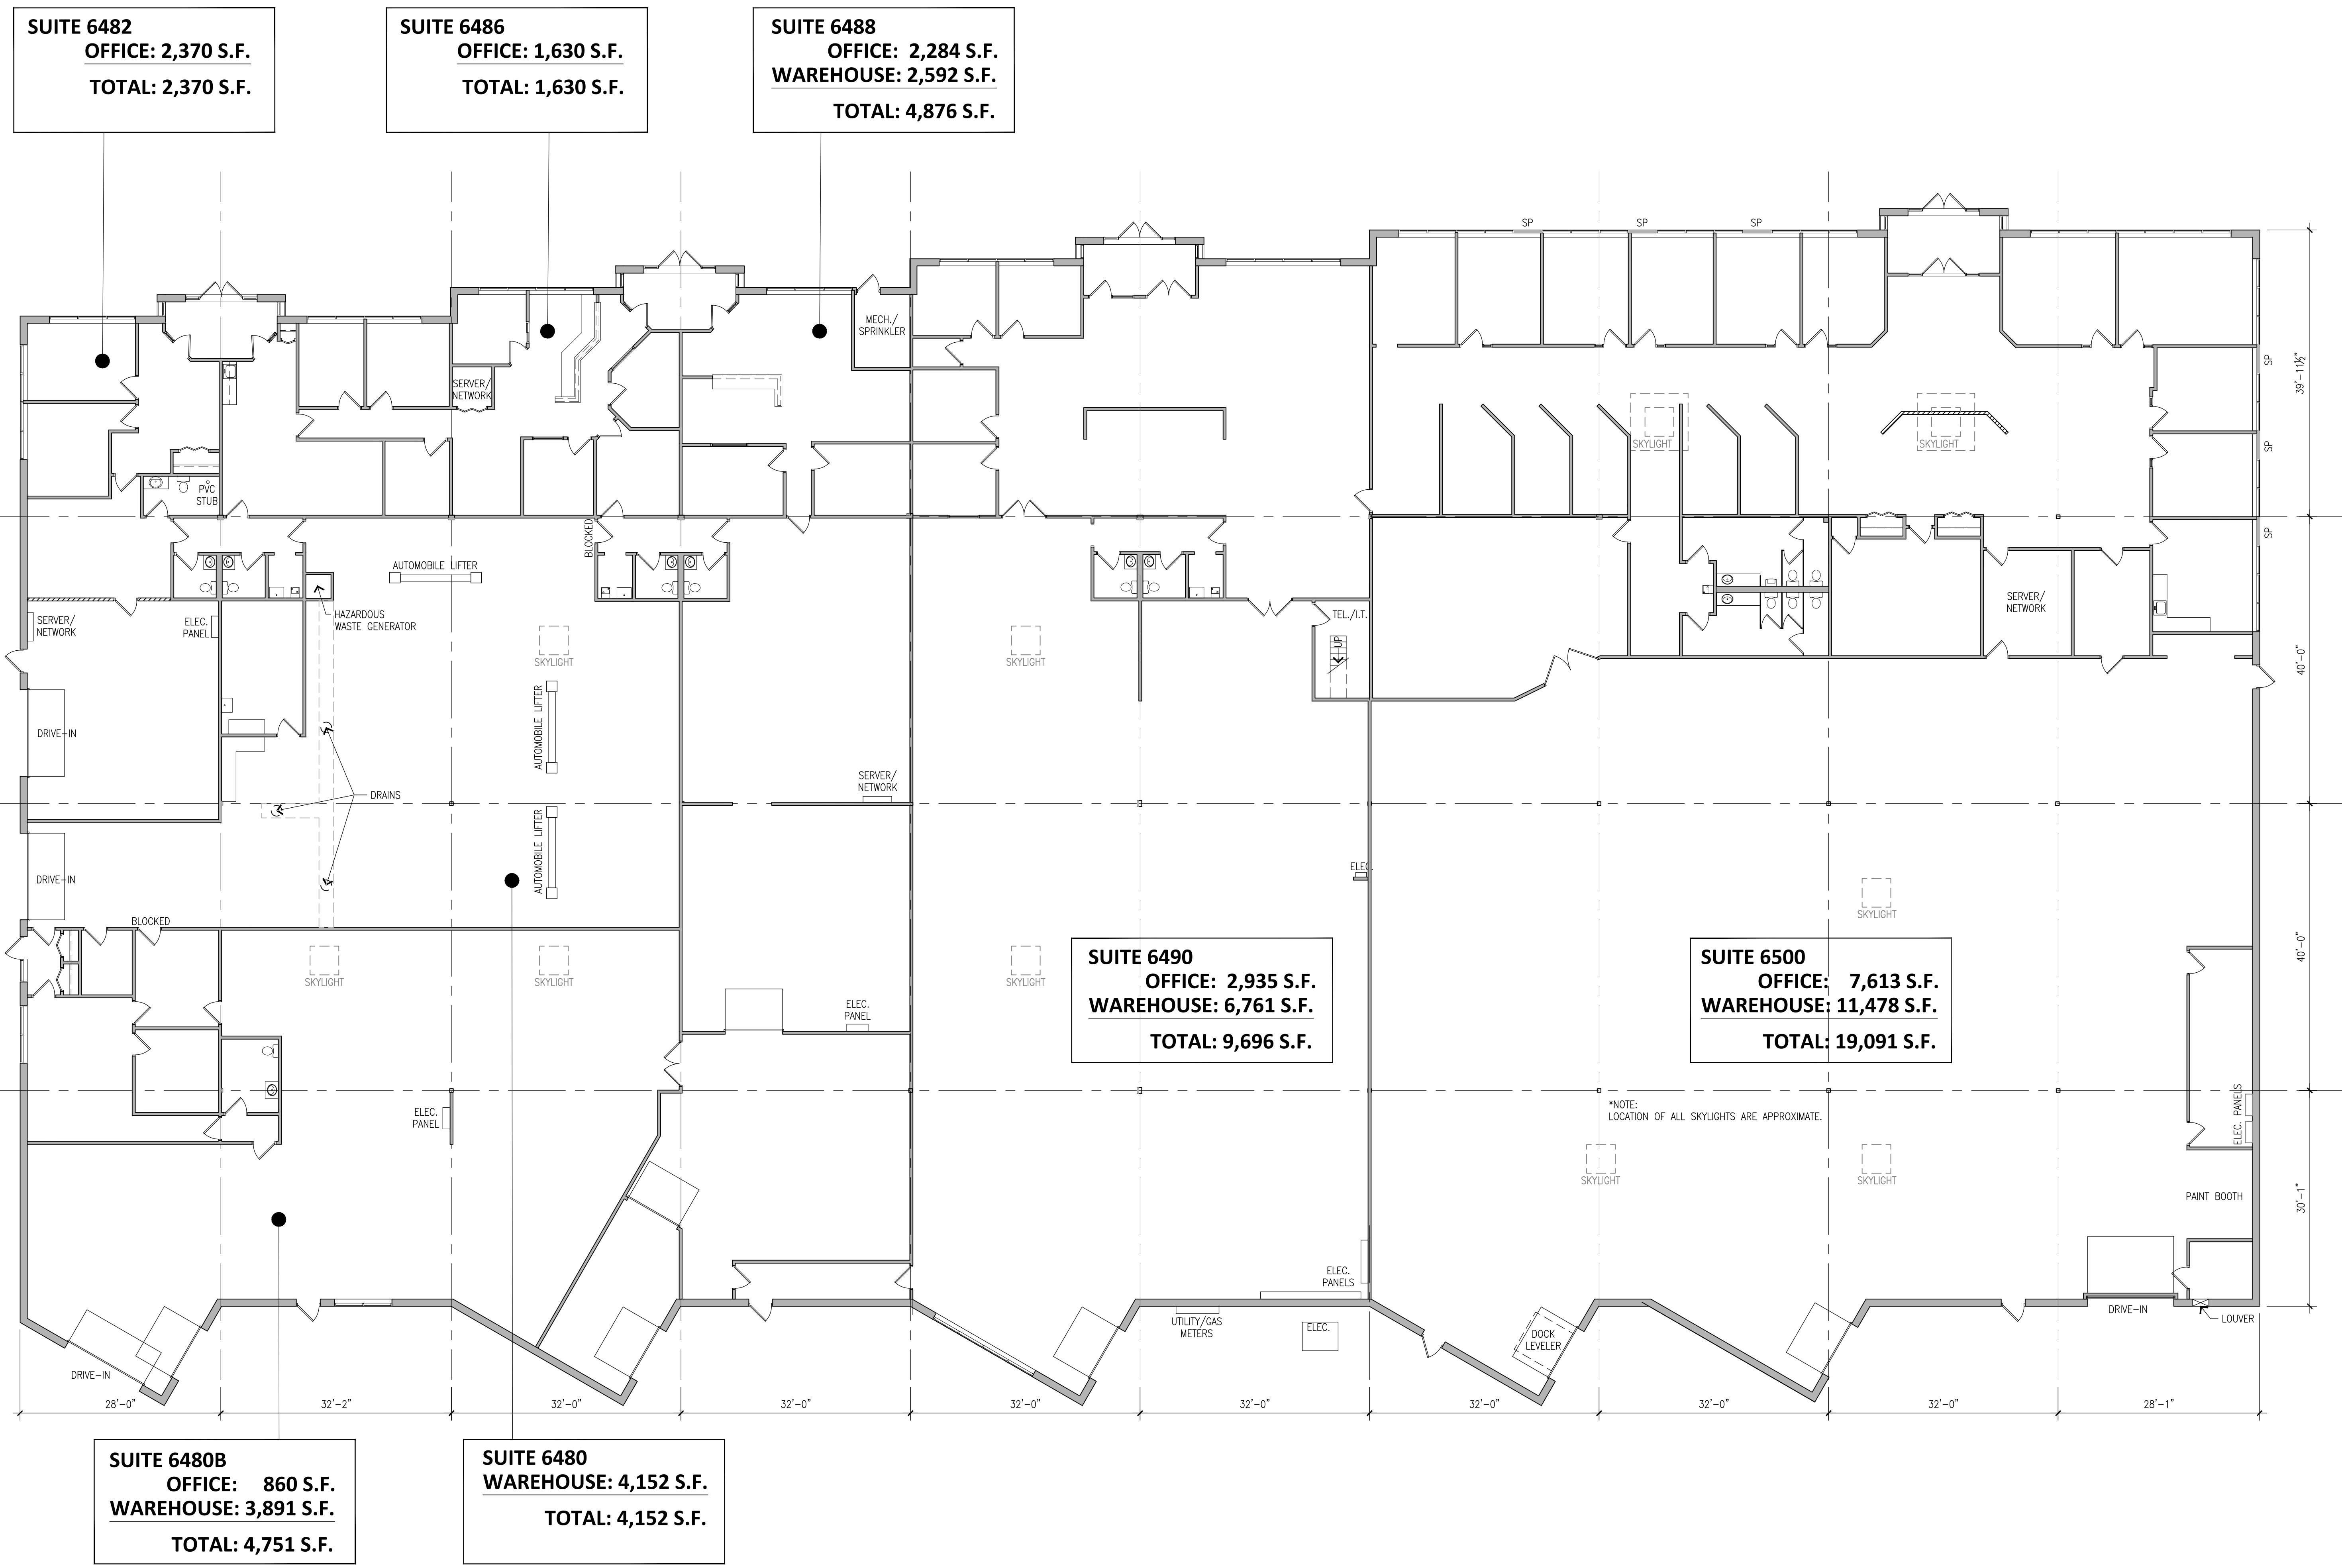

SUITE 6482
OFFICE: 2,370 S.F.
TOTAL: 2,370 S.F.

SUITE 6486
OFFICE: 1,630 S.F.
TOTAL: 1,630 S.F.

SUITE 6488
OFFICE: 2,284 S.F.
WAREHOUSE: 2,592 S.F.
TOTAL: 4,876 S.F.

SUITE 6490
OFFICE: 2,935 S.F.
WAREHOUSE: 6,761 S.F.
TOTAL: 9,696 S.F.

SUITE 6500
OFFICE: 7,613 S.F.
WAREHOUSE: 11,478 S.F.
TOTAL: 19,091 S.F.

SUITE 6480B
OFFICE: 860 S.F.
WAREHOUSE: 3,891 S.F.
TOTAL: 4,751 S.F.

SUITE 6480
WAREHOUSE: 4,152 S.F.
TOTAL: 4,152 S.F.

*NOTE: LOCATION OF ALL SKYLIGHTS ARE APPROXIMATE.